
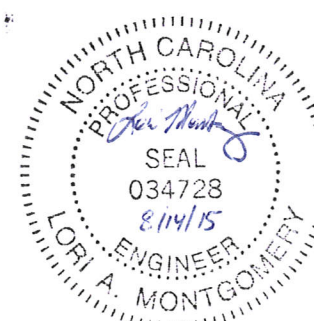


NOTES

1. This drawing taken from 1996 plan set completed by Hazen & Sawyer for anaerobic digester project, and may not reflect all current conditions.
2. Items shown in red denote revisions made by City of Durham Department of Water Management to provide necessary information for the 2015 Influent Pump Station Rehabilitation Project.
3. Contractor shall verify all conditions in the field prior to start of bypass pumping.
4. Prior to start of bypass pumping, Contractor shall submit a written plan for Owner approval, pursuant to Specification 01 52 50.
5. Contractor shall transfer flow from Bypass Pump Locations 1, 2 and 3 (shown on Sheet 2) to the Primary Treatment Facilities Junction Box (Sheet 5).
6. See bypass pumping requirements in Specification 01 52 50.

LEGEND		
DEMOLITION	NEW	EXISTING
		BUILDING / STRUCTURE
		CONCRETE PAVEMENT
		ASPHALT PAVEMENT
		TREE LINE

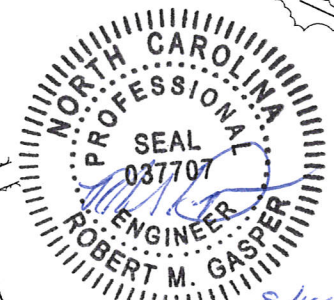

OVERALL SITE PLAN - SOUTH DURHAM WATER RECLAMATION FACILITY

"Not a Certified Document as to the Original Document, but only as to the Revisions. This Document originally issued and sealed by Joseph B. Meeks, Jr. (PE 10118) and Gordon C. Ruggles (PE 8378) on 5/96 as a construction drawing. This document is only certified as to the revisions."

					DESIGNED _____	CITY OF DURHAM, NORTH CAROLINA DEPARTMENT OF WATER RESOURCES	SOUTH DURHAM WATER RECLAMATION FACILITY GENERAL OVERALL SITE PLAN	Not to Scale	
					DRAWN _____				
					CHECKED _____				
					PROJ. ENGR. _____				
1	Issued for Bid	08/15				SDWRF INFLUENT PUMP STATION REHAB PROJECT		SHEET 1	OF 6
NO.	ISSUED FOR	DATE	BY	APPROVED					

DISCHARGE LOCATION FOR BYPASS PUMPING LOCATIONS 1, 2 AND 3 WILL BE AT PRIMARY TREATMENT FACILITIES JUNCTION BOX (SHOWN ON SHEET 1 AND SHEET 5)

Bypass Pump Location	MH Top EL (ft)	MH Outlet EL (ft)	MH Bottom EL (ft)	Peak Flow Potential (MGD)	Average Flow Expected (MGD)	Maximum Water Elevation Allowed	Flow Discharge Location
1	241.29	222.89	unknown	60	7-15	226.0 ft EL	PTF Junction Box
2	243.00	234.63	234.50	4.5	0.7-1.0	No surcharging of upstream manholes/drains	PTF Junction Box
3	241.14	226.52	unknown	4.0	0.4-0.6	No surcharging of upstream manholes/drains	PTF Junction Box

- NOTES
1. This drawing taken from 1991 plan set completed by Hazen & Sawyer for plant expansion.
 2. Items shown in red denote revisions made by City of Durham Department of Water Management to provide necessary information for the 2015 Influent Pump Station Rehabilitation Project.
 3. Contractor shall verify all conditions in the field prior to start of bypass pumping.
 4. Prior to start of bypass pumping, the Contractor shall submit a written plan for Owner approval, pursuant to Specification 01 52 50.
 5. Contractor shall transfer flow from Bypass Pump Locations 1, 2 and 3 to the Primary Treatment Facilities Junction Box (See Sheets 2 and 5).
 6. See bypass pumping requirements in Specification 01 52 50.
 7. Contractor shall install a new 36" eccentric seating plug valve in accordance with Specification 15 10 90. 36" DIP: Center line exits pump station at EL = 234.50, Ground surface EL approx. 241.0. Force main profile shown Sheet 6.
 8. 36" plug valve shall be located in a 10' X 10' precast concrete vault with fully opening top, to be provided by Contractor - See Specification 03 11 48.
 9. The floor of vault shall be a minimum of 18" below bottom of 36" force main pipe. Top of vault shall include a 6'X4' (minimum) aluminum watertight double leaf access door with H-20 traffic rating and sign "confined space do not enter" inside on leaf.
 10. Plug valve shall be centered horizontally in vault and installed in the vertical position to provide room for future actuator installation (actuator is not included in this project). Contractor shall provide watertight seal around all pipe penetrations.
 11. Contractor shall provide all miscellaneous materials and fittings to connect the valve installation to the force main.
 12. Contractor shall plug 36" FM to prevent back flow from Primary Treatment Facilities Junction box during plug valve installation.

INSTALL 36" PLUG VALVE
Exact location to be coordinated with owner in field.
See Notes 7, 8, 9, 10, 11 AND 12.
See Sheets 4 and 6.

BYPASS PUMP LOCATION 2
See Notes 3, 4, 5 and 6.



BYPASS PUMP LOCATION 1
See Notes 3, 4, 5 and 6.

INFLUENT VAULT
Bottom EL - 220.0'
Top EL - 242.0'

BYPASS PUMP LOCATION 3
See Notes 3, 4, 5 and 6.


CLOSE VALVE ON 6" DRAIN DURING BYPASS PUMPING

SLUDGE DRYING BED DRAIN SYSTEM - CONTRACTOR TO PLUG DURING BYPASS PUMPING

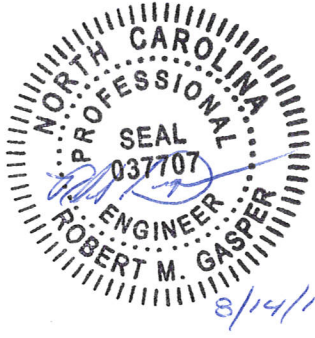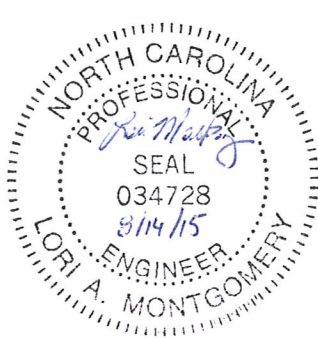

PIPING LEGEND

A	=	PROCESS AIR	PSD	=	PERFORATED STRUCTURE DRAIN
ALS	=	ALUM SOLUTION	PW	=	POTABLE WATER
CG	=	CHLORINE GAS	RAS	=	RETURN ACTIVATED SLUDGE
CLS	=	CHLORINE SOLUTION	RCW	=	RECLAIMED WATER
CS	=	CAUSTIC SOLUTION	RW	=	RAW WASTEWATER
D	=	DRAIN	S	=	SAMPLE
DPS	=	DIGESTED PRIMARY SLUDGE	SC	=	SCUM
DS	=	DIGESTED SLUDGE	SD	=	STORM DRAIN
DSU	=	DIGESTER SUPERNATANT	SDO	=	SLUDGE DRAW-OFF
DWAS	=	DIGESTED WASTE ACTIVATED SLUDGE	SPD	=	SUMP PUMP DISCHARGE
FCE	=	FINAL CLARIFIER EFFLUENT	SPR	=	SCRUBBER PUMP RECIRCULATION
FE	=	FLOCCULATOR EFFLUENT	SPS	=	SCRUBBER PUMP SUCTION
FTE	=	FILTERED TERTIARY EFFLUENT	SS	=	SANITARY SEWER
ML	=	MIXED LIQUOR SUSPENDED SOLIDS	SW	=	SEAL WATER
NG	=	NATURAL GAS	TWAS	=	THICKENED WASTE ACTIVATED SLUDGE
P	=	POLYMER	WAS	=	WASTE ACTIVATED SLUDGE
PI	=	PRIMARY INFLUENT	WASTS	=	WAS THICKENER SUPERNATANT
PS	=	PRIMARY SLUDGE			

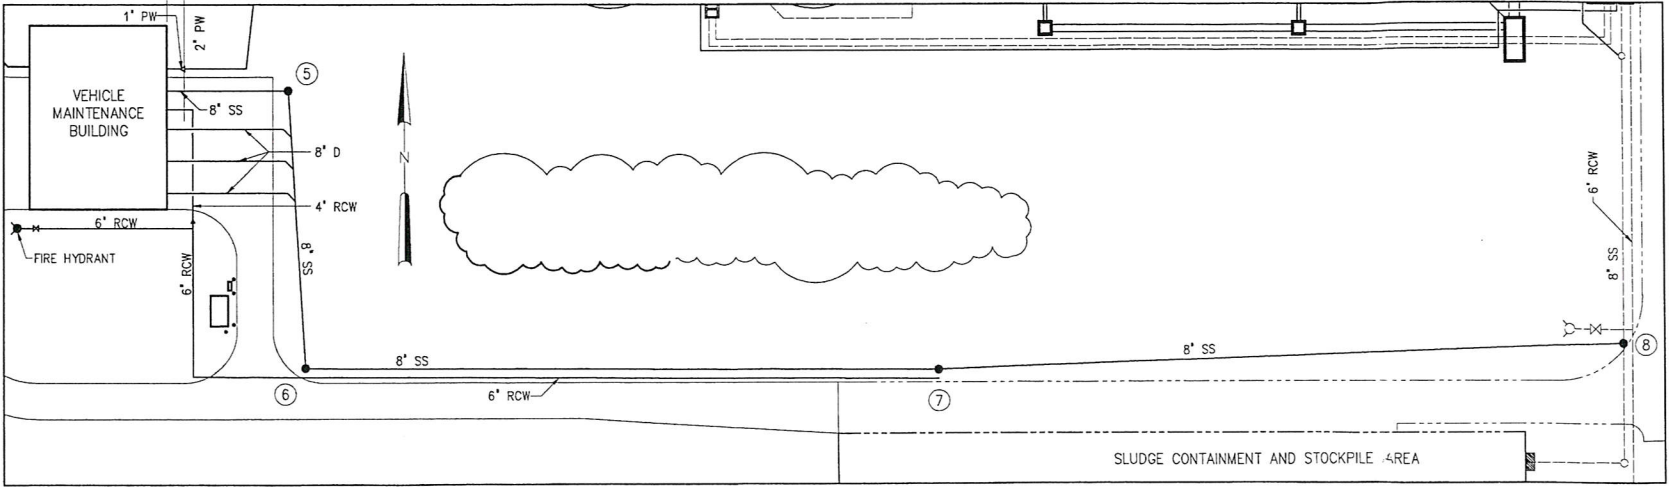

VEHICLE MAINTENANCE BUILDING
TO SLUDGE DRYING BEDS


"Not a Certified Document as to the Original Document, but only as to the Revisions. This Document originally issued and sealed by Joseph B. Meeks, Jr. (PE 10118) and Gordon C. Ruggles (PE 8378) of Hazen and Sawyer, PC on 5/95 as a record drawing. This document is only certified as to the revisions."

					DESIGNED _____
					DRAWN _____
					CHECKED _____
					PROJ. ENGR. _____
1	Issued for Bid	08 15			
NO.	ISSUED FOR	DATE	BY		APPROVED _____

CITY OF DURHAM, NORTH CAROLINA
DEPARTMENT OF WATER MANAGEMENT
SDWRF INFLUENT PUMP STATION REHAB
PROJECT

YARD PIPING

Not to Scale

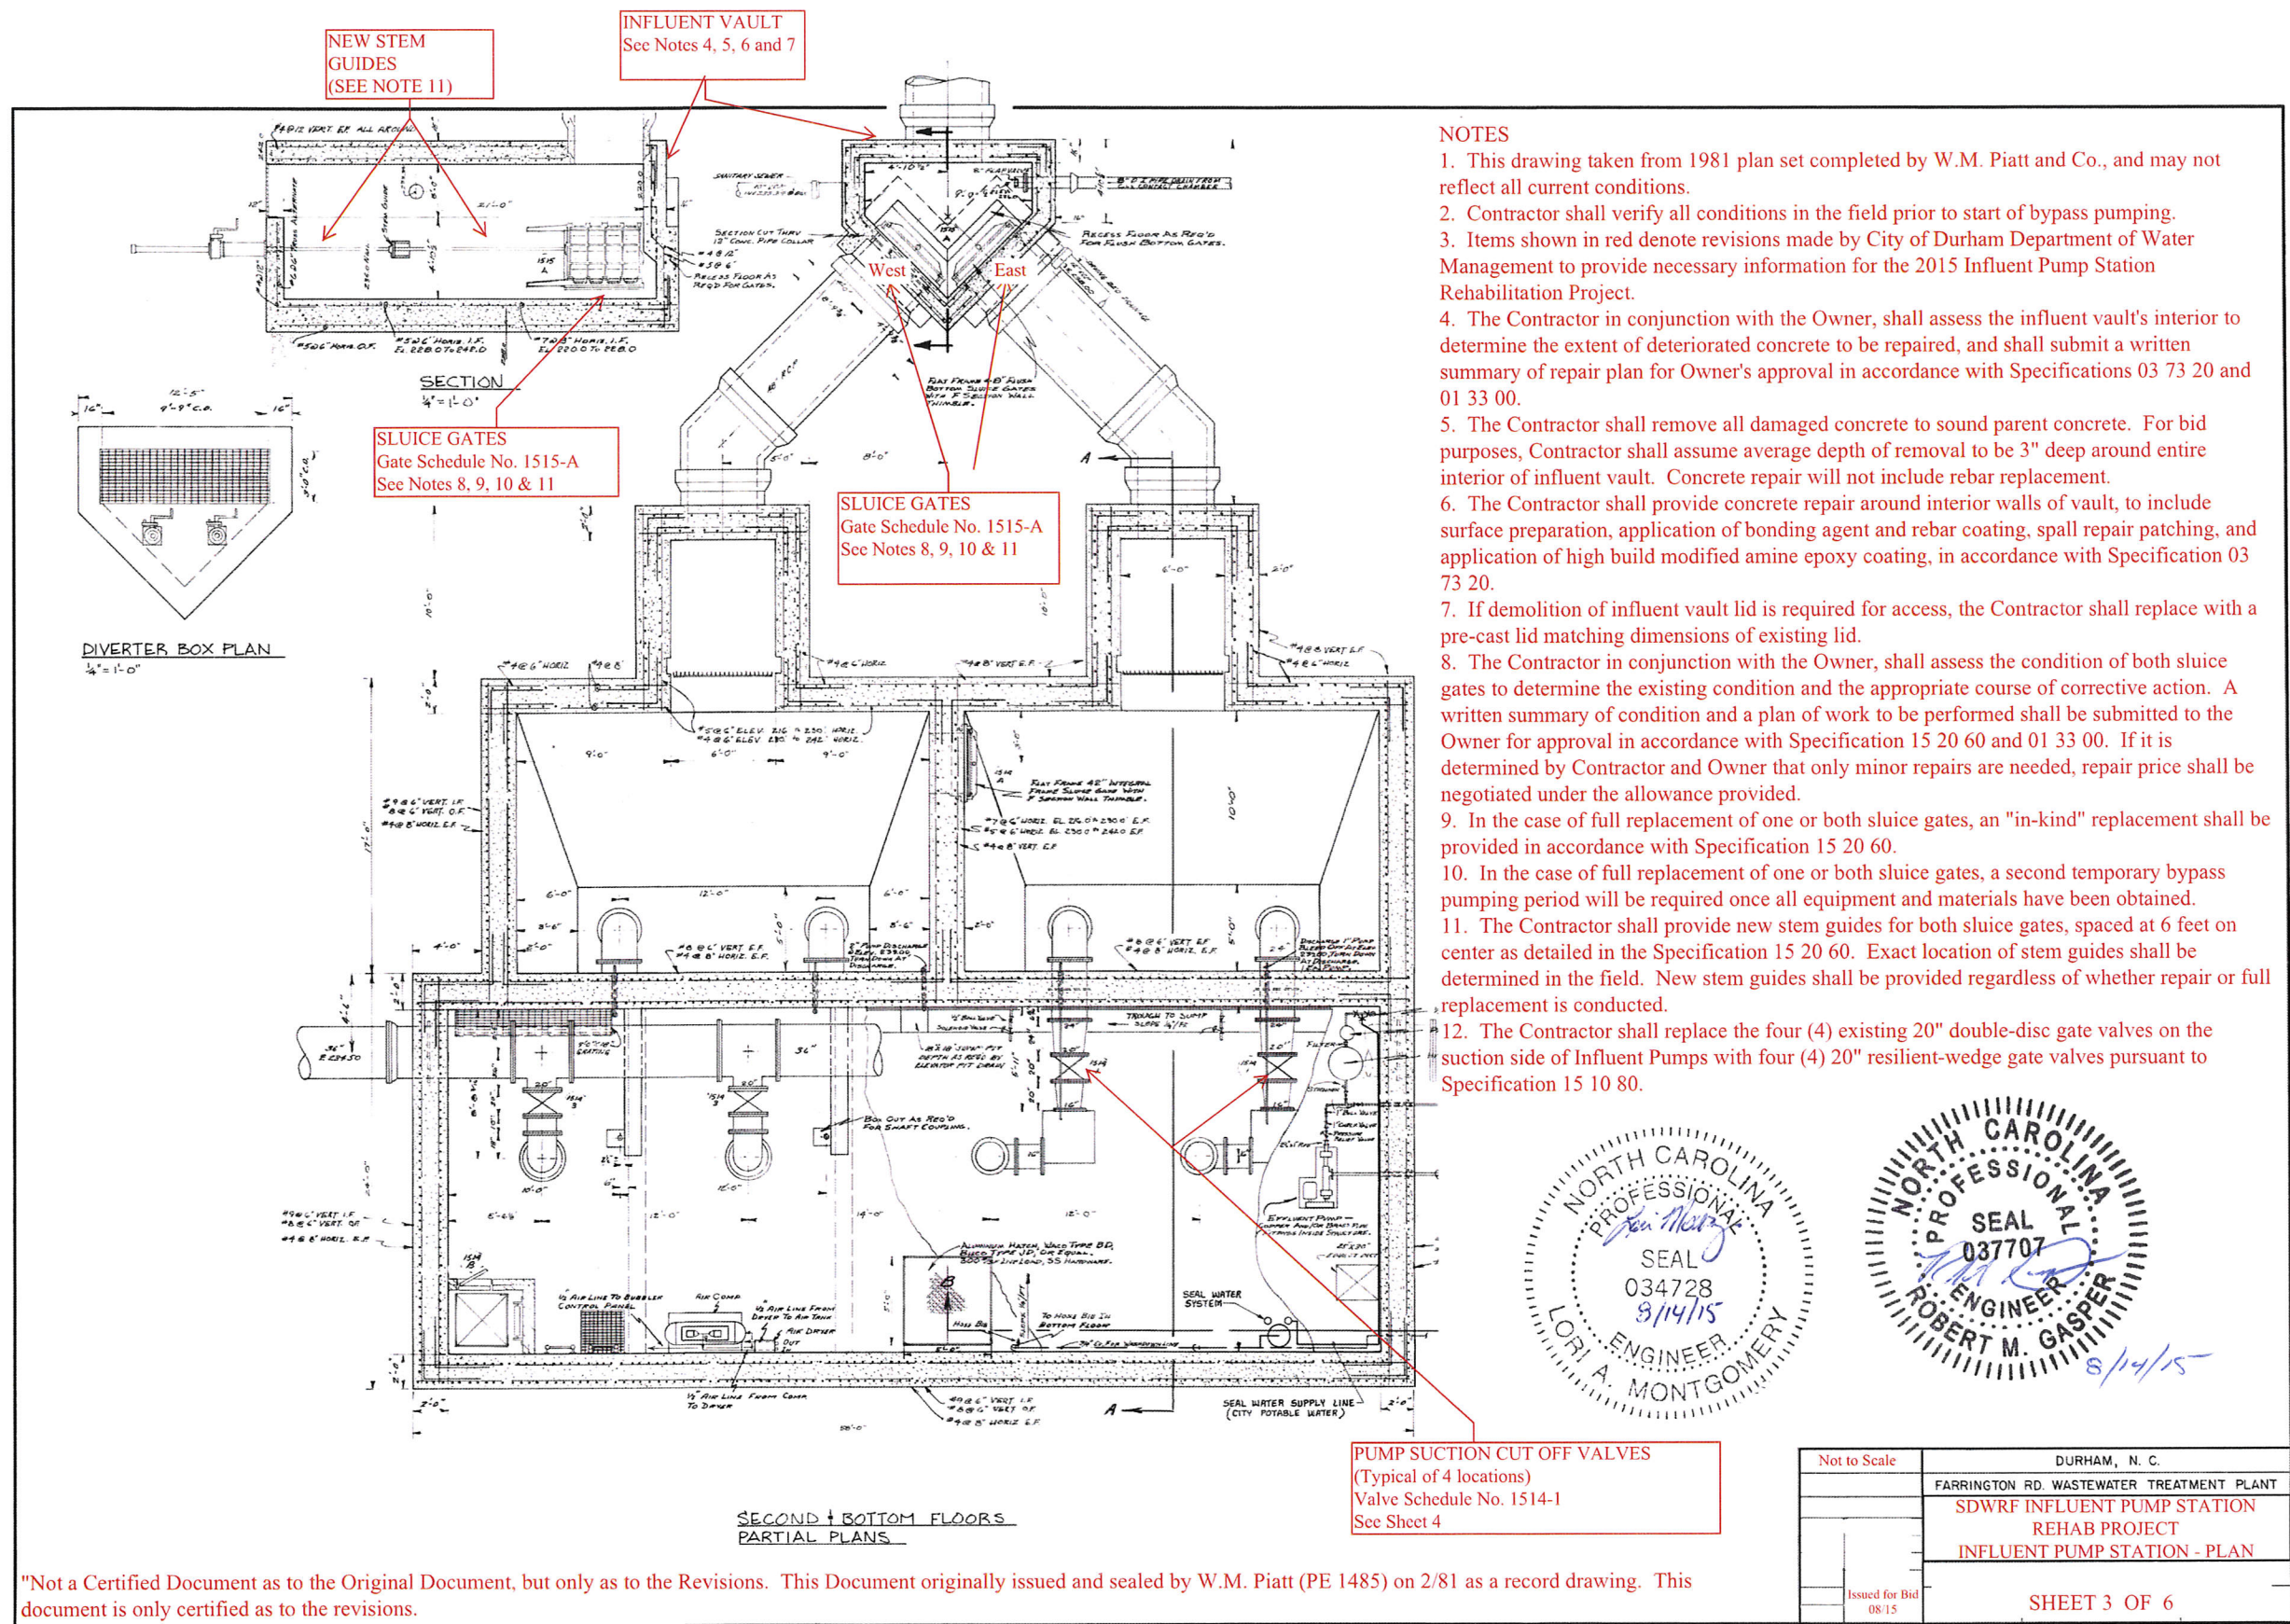

"Not a Certified Document as to the Original Document, but only as to the Revisions. This Document originally issued and sealed by W.M. Piatt (PE 1485) on 2/81 as a record drawing. This document is only certified as to the revisions.





Photo 1: Side view of Valve No. 1 to be replaced. Typical of four locations.



Photo 2: View of Valve No. 3 to be replaced. Typical of four locations.

NOTES:

1. This drawing taken from 1991 plan set completed by Hazen and Sawyer, P.C., and may not reflect all current conditions.
2. Contractor shall verify all conditions in the field prior to start of work.
3. Items shown in red denote revisions made by City of Durham Department of Water Management to provide necessary information for the 2015 Influent Pump Station Rehabilitation Project.
4. Contractor shall replace the four (4) existing 20" double-disc gate valves on the suction side of Influent Pumps with four (4) 20" resilient wedge gates valves pursuant to Specification 15 10 80.

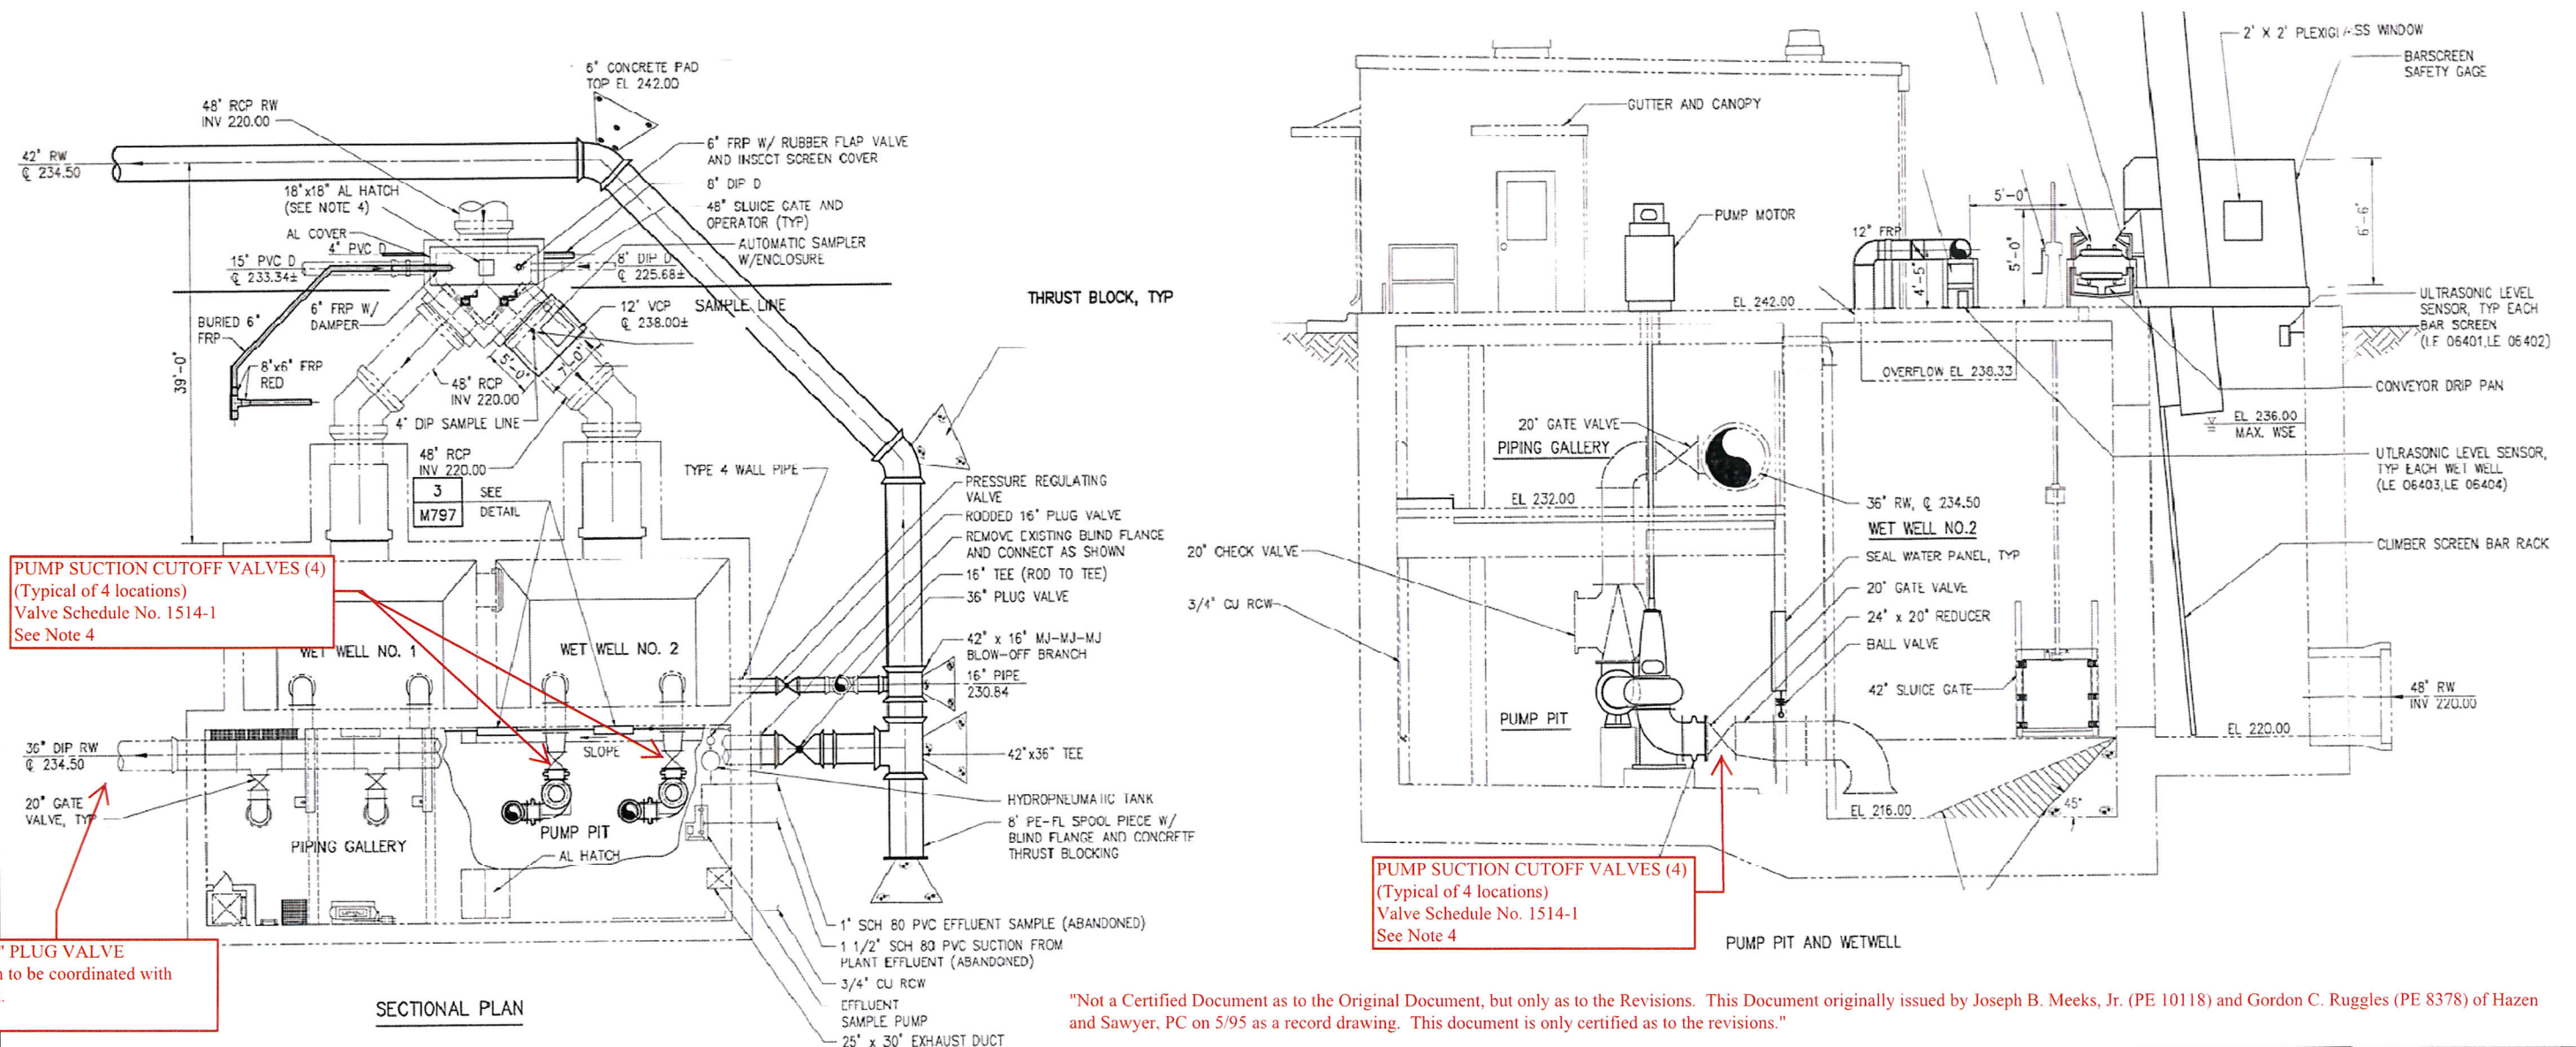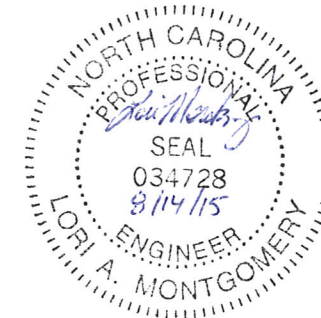

"Not a Certified Document as to the Original Document, but only as to the Revisions. This Document originally issued by Joseph B. Meeks, Jr. (PE 10118) and Gordon C. Ruggles (PE 8378) of Hazen and Sawyer, PC on 5/95 as a record drawing. This document is only certified as to the revisions."

CITY OF DURHAM, NORTH CAROLINA
DEPARTMENT OF WATER MANAGEMENT

SDWRF INFLUENT PUMP STATION
REHAB PROJECT


INFLUENT PUMP STATION/
GENERATOR BUILDING
MECHANICAL
PLANS AND SECTION

Not to Scale



SHEET 4 OF 6

Issued for Bid 08/15


DESIGNED
DRAWN
CHECKED
PROD. ENGR.

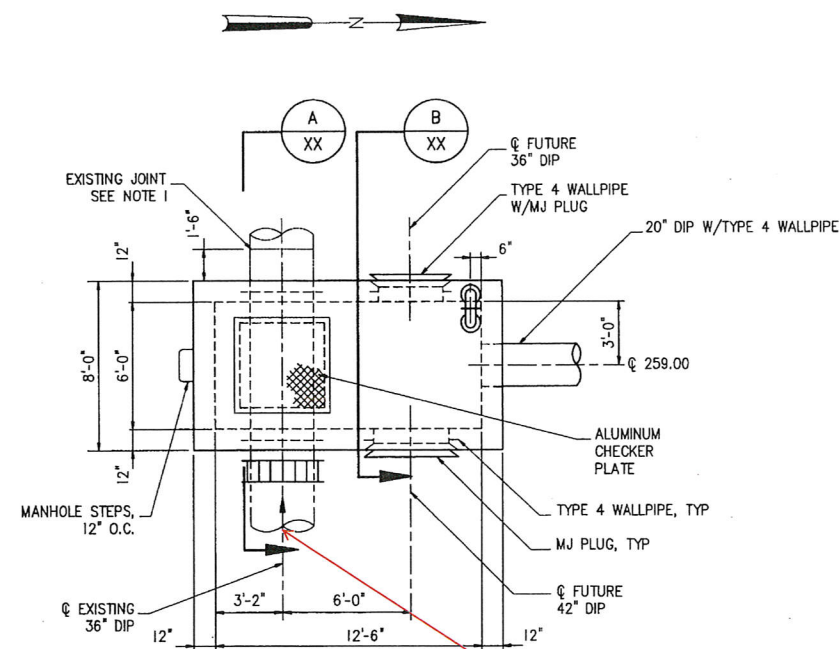

CONTRACTOR SHALL PLUG 36" FORCE MAIN TO PREVENT BACKFLOW FROM PRIMARY TREATMENT FACILITIES JUNCTION BOX DURING PLUG VALVE INSTALLATION.

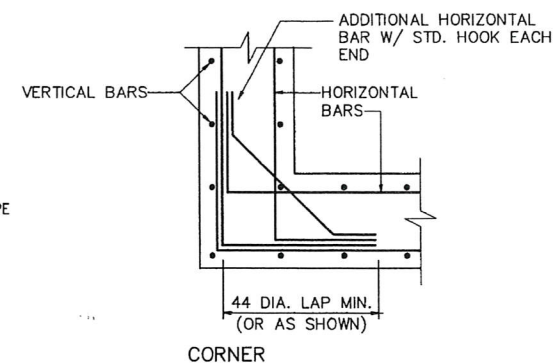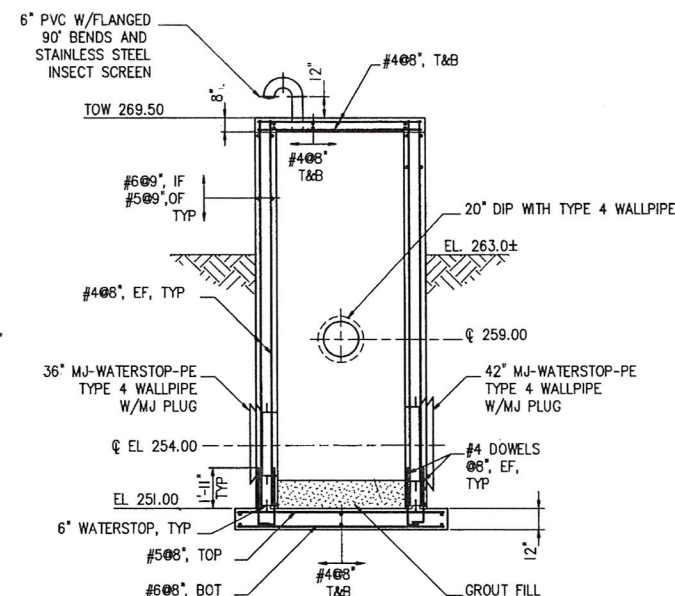





PLACE EXTRA BARS AT EACH SIDE OF OPENINGS EQUAL TO HALF THE CROSS-SECTIONAL AREA OF THE INTERRUPTED BAR (TYPICAL EACH FACE). EXCEPT WHERE NOTED OTHERWISE, PROVIDE ONE DIAGONAL BAR EACH SIDE OF OPENING, SIZE TO BE EQUAL TO MAIN REINFORCING. (TYPICAL EACH FACE)

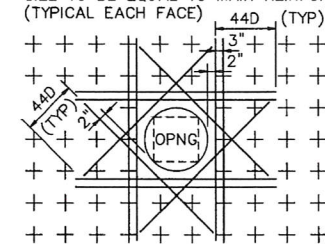

NOTE: THIS DETAIL IS FOR OPENINGS 8" OR LARGER, FOR SMALLER OPENINGS, BEND BARS.

TYP. REINF. AT OPENINGS IN SLABS AND WALLS

DETAIL 2
NOT TO SCALE XX

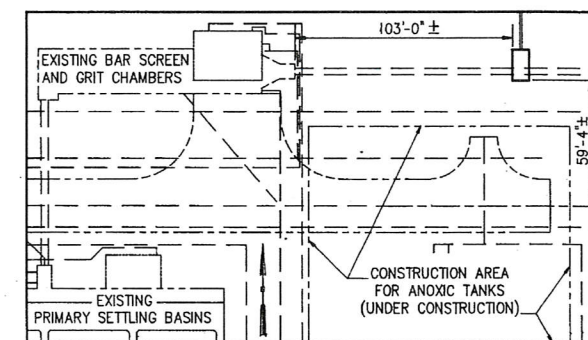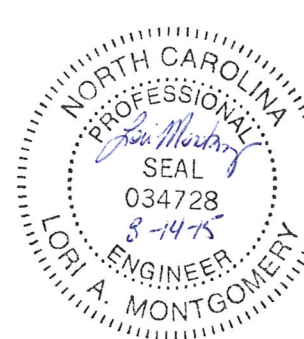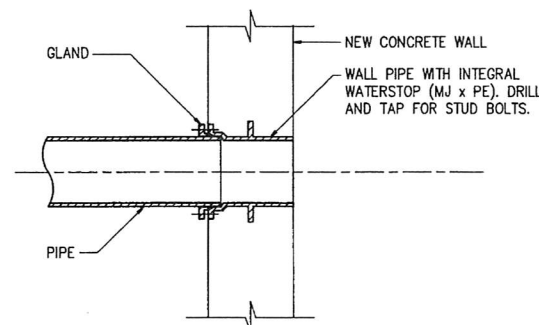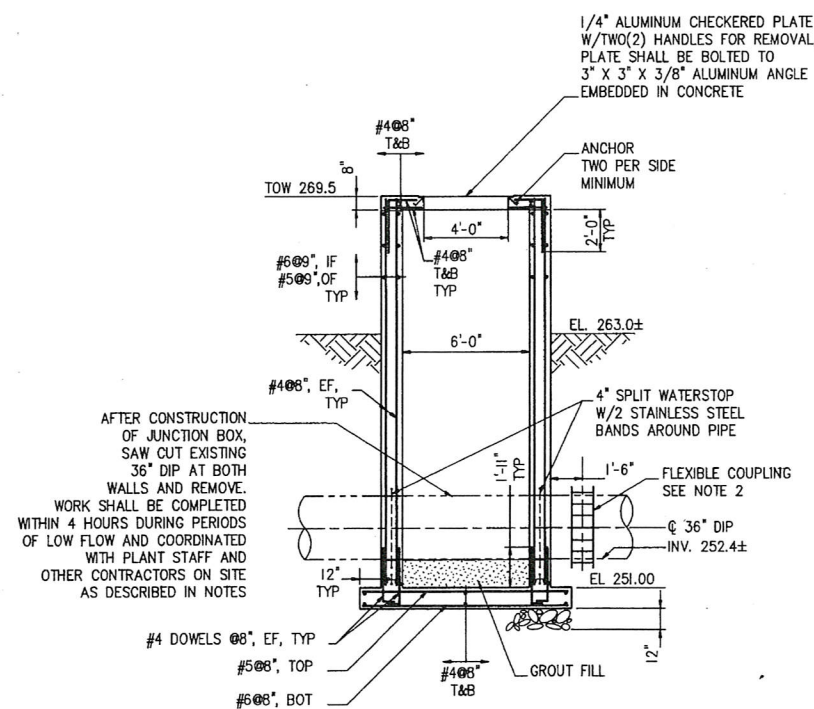

No: 6803

Old Index # DD-46 (Water & Sewer)

SYSTEM	DESIGN BY	DRAWN BY	CONSTRUCTION DATE	REVISIONS
WATER				
SAN. SEWER				
STW. SEWER				
STREET IMP.				

Not to Scale
Issued for Bid 08/15

CITY OF DURHAM
ENGINEERING DEPARTMENT
PRELIMINARY TREATMENT FACILITY
DISTRIBUTION BOX
FARRINGTON ROAD WASTEWATER TREATMENT PLANT

SHEET 5 of 6

